


- NOTES:**
- (1) LAMP POSTS NOT SHOWN. FOR DETAIL SEE DRG. REG. NO. 28 921/52.
- (2) CORNERS PROVIDED WITH 40mm CHAMFERS.
- DIMENSIONS MEASURES FROM AS BUILT STRUCTURE

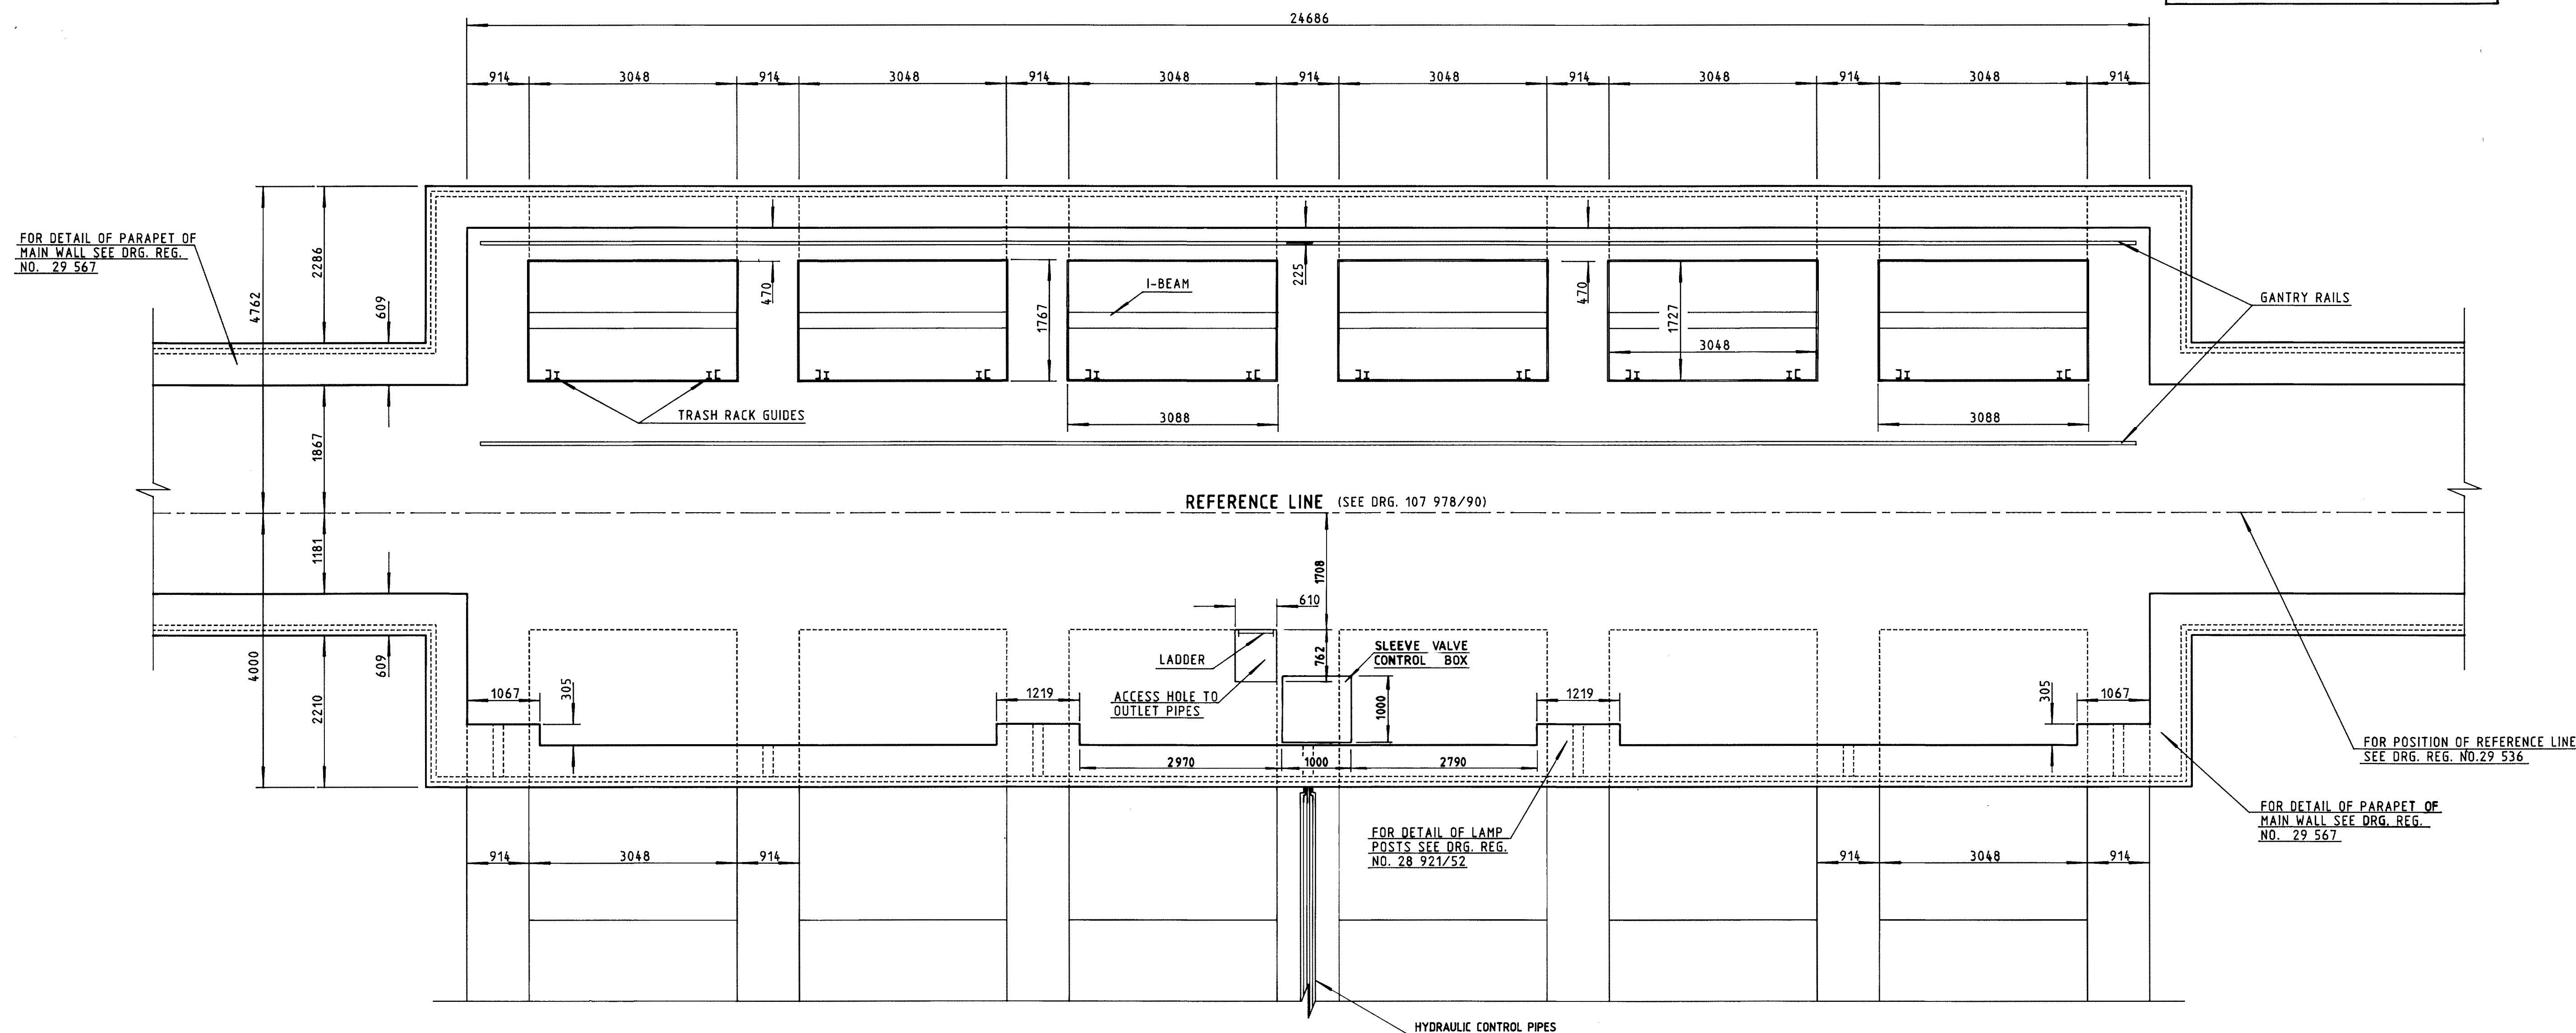

PLAN OF OUTLET BLOCK
(FOR SECTIONS THROUGH OUTLET BLOCK SEE
DRG'S. REG. NO. 29 536/35 AND 25 433/50)
SCALE 1 : 50



AS BUILT

LIST OF DRAWINGS	
COMPLETION PLAN : RADIAL GATE	
OUTLETS	29 536/52ME
DETAILS OF PROPOSED PARAPET	28 921/52
DRAINAGE AND PARAPET DETAILS	29 567/59
1/3 RIVER OUTLET DISCHARGE AND	
RESERVOIR DRAWDOWN CURVES	107 976/90
2/3 OUTLET STRUCTURE: SECTION THROUGH	
RIVER OUTLET	107 978/90
VEL SHEET	BESKRYWING DESCRIPTION
ANDER N°: OTHER No.	GEREG N°: REG No.

HERSIENING / REVISION		DEPARTEMENT VAN WATERWESE HOOFKANTOOR DIREKTORAAT ONTWERP PRIVAATSAK		DEPARTMENT OF WATER AFFAIRS HEAD OFFICE DESIGN DIRECTORATE PRIVATE BAG		REPUBLIEK VAN SUID-AFRIKA DEPARTEMENT VAN WATERWESE		REPUBLIC OF SOUTH AFRICA DEPARTMENT OF WATER AFFAIRS	
MOD N°/No.	DATUM DATE	BESKRYWING DESCRIPTION	VIR FOR	W-WESE W.A.					
				G.C.D. CLAASSENS DIREKTEUR - GENERAAL / DIRECTOR GENERAL					
				ONTWERP: AS BUILT DESIGNED: CADD					
				GETEKEN: H. KRIEL DRAWN: CHECKED: 14/11/12					
				GOEDGEKEUR / APPROVED HANDTEKENING SIGNATURE					
				INGENIEUR: RANG RANK ADJUNK-INGENIEUR DEPUTY CHIEF ENGINEER					
				PROVINSE: KAAP/CAPE DISTRIK: JANSENVILLE SLEUTELKODES KEY CODES: DRG					
				LAKE MENTZ PLAN AANSIG VAN UITLAAT STRUKTUUR					
				TENDER N°/No. KONTRAK N°: LOCALITEIT N°: N230-01					
				ANDER N°: OTHER No.					
				VEL / SHEET 3 OF 3					
				REG N° / No. 108057 / 90					